2 EXISTING ROOF PLAN

1/16"

AERIAL PHOTO OVERLAY ON FLOOR PLAN FOR REFERENCE

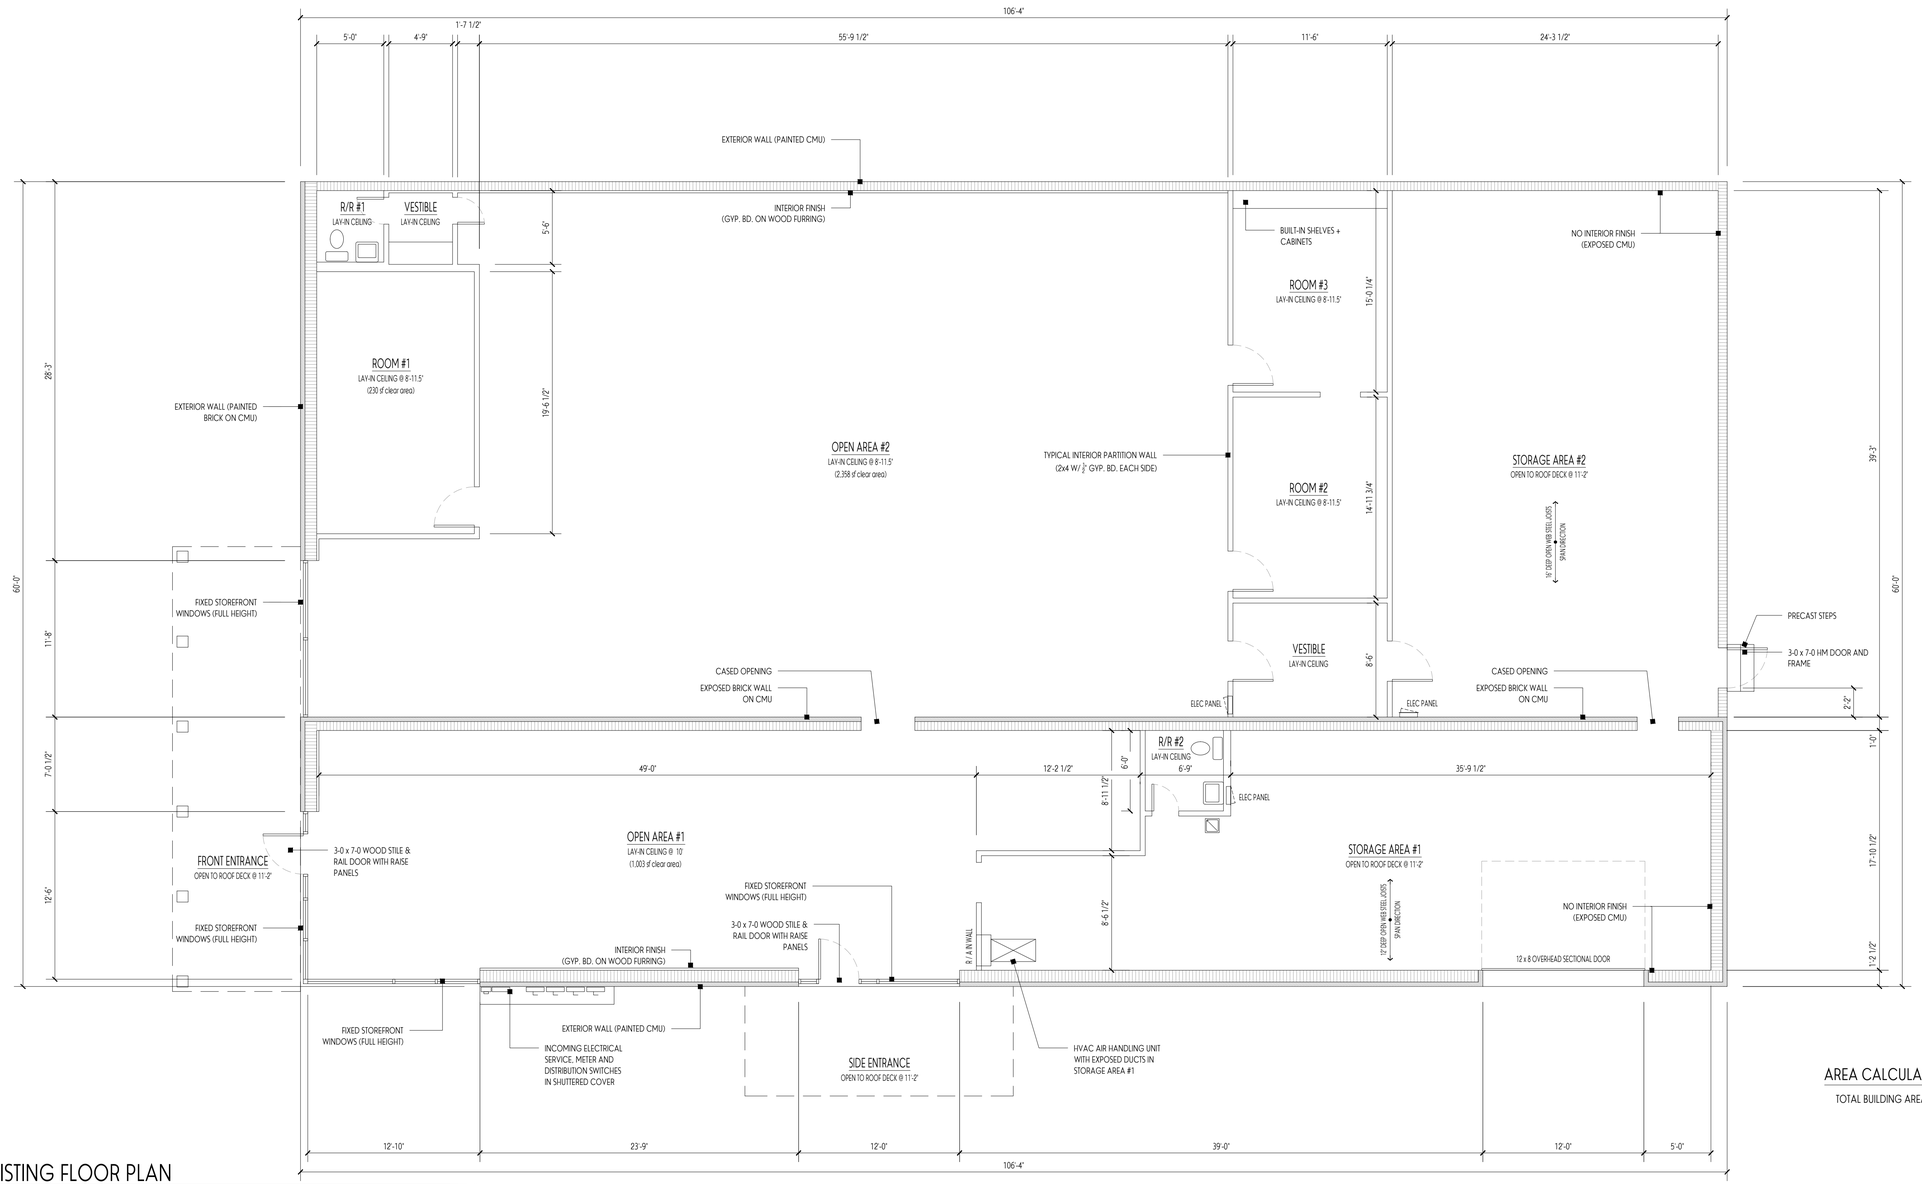

1 EXISTING FLOOR PLAN

3/16"

AREA CALCULATION

TOTAL BUILDING AREA	6,380 SF

ARCHITECT:

JAMES DESHOTELS ARCHITECT

7857 JEFFERSON HWY BATON ROUGE LA 70809 DESHOTELS.ARCHITECT@GMAIL.COM 225.241.8402

PROJECT:

TAYLOR CLARK BUILDING

EXISTING PLAN

2623 GOVERNMENT STREET
BATON ROUGE, LOUISIANA 70806

SEAL:

Xref ..\..\..\..\10-office\The Vault\JDDstamp.dwg

DATE:	DESCRIPTION:
10.28.20	ISSUED DRAWING

PROJECT NO: 23.2320

PROJECT PHASE:

EXISTING DOCUMENTATION

SHEET TITLE:

EXISTING CONDITIONS

SHEET NO.:

A1